


NOTE TO EXCAVATOR

Excavator must notify all utilities at least 48 hours and not more than 10 days prior to the planned commencement of excavation.


1. Member utilities will be contacted by calling OUPS (1-800-362-2764).
2. Each Limited Basis Participant will be contacted by the excavator using the telephone number provided.

UNDERGROUND UTILITIES AT EXCAVATION SITE

| Utility | | | Member OUPS | Limited Basis Participants |
|---------|---------|-----------|-------------|----------------------------|
| Name | Address | Phone No. | | |
| | | | | |
| | | | | |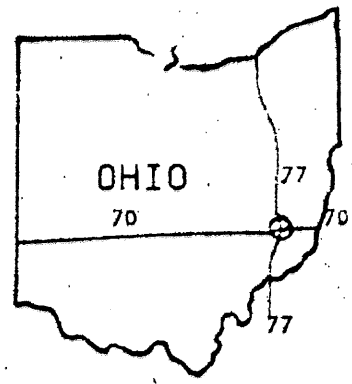
VICINITY MAP

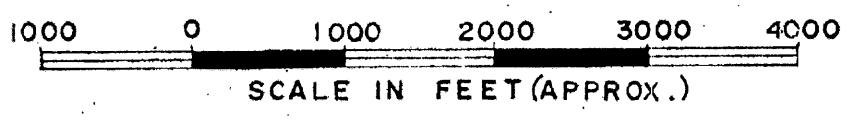

LEGEND

- STATE HIGHWAY----- (209)
- UNITED STATES ROUTE----- (40)
- INTERSTATE ROUTE----- (77)
- CORPORATION LIMITS-----

AS-BUILT

11/11/92

WORK LOCATION MAP
SOUTHGATE DIKE, CITY OF CAMBRIDGE
WILLS CREEK WATERSHED (PL-566)
GUERNSEY CO., OHIO

**U. S. DEPARTMENT OF AGRICULTURE
SOIL CONSERVATION SERVICE**

| | | |
|----------------------|------|---|
| Design: R. S. YEDMAN | 3/87 | |
| Drawn: E.W. MCGUIRE | 9/87 | |
| Field: T.L. RUCH | 6/90 | 2 |
| | | 9 |

OH-870107