


CURVE TABLE

CURVE	RADIUS	TANGENT	LENGTH	DELTA	DEGREE	CHORD	CH. BEARINGS
#1	184.83'	23.79'	47.32'	14° 40' 09"	31° 00' 00"	47.19'	N 07° 33' 02" W
#2	140.00'	10.93'	21.81'	8° 55' 32"	40° 55' 32"	21.79'	N 19° 20' 53" W
	140.00'	25.27'	50.00'	20° 27' 46"	40° 55' 32"	49.73'	N 34° 02' 32" W
	140.00'	25.27'	50.00'	20° 27' 46"	40° 55' 32"	49.73'	N 54° 30' 18" W
	140.00'	25.27'	50.00'	20° 27' 46"	40° 55' 32"	49.73'	N 74° 58' 04" W
	140.00'	25.27'	50.00'	20° 27' 46"	40° 55' 32"	49.73'	S 84° 34' 10" W
	140.00'	5.03'	10.06'	4° 06' 58"	40° 55' 32"	10.06'	S 72° 16' 48" W
H2-L	140.00'	152.50'	231.87'	94° 53' 34"	40° 55' 32"	206.26'	N 62° 19' 54" W

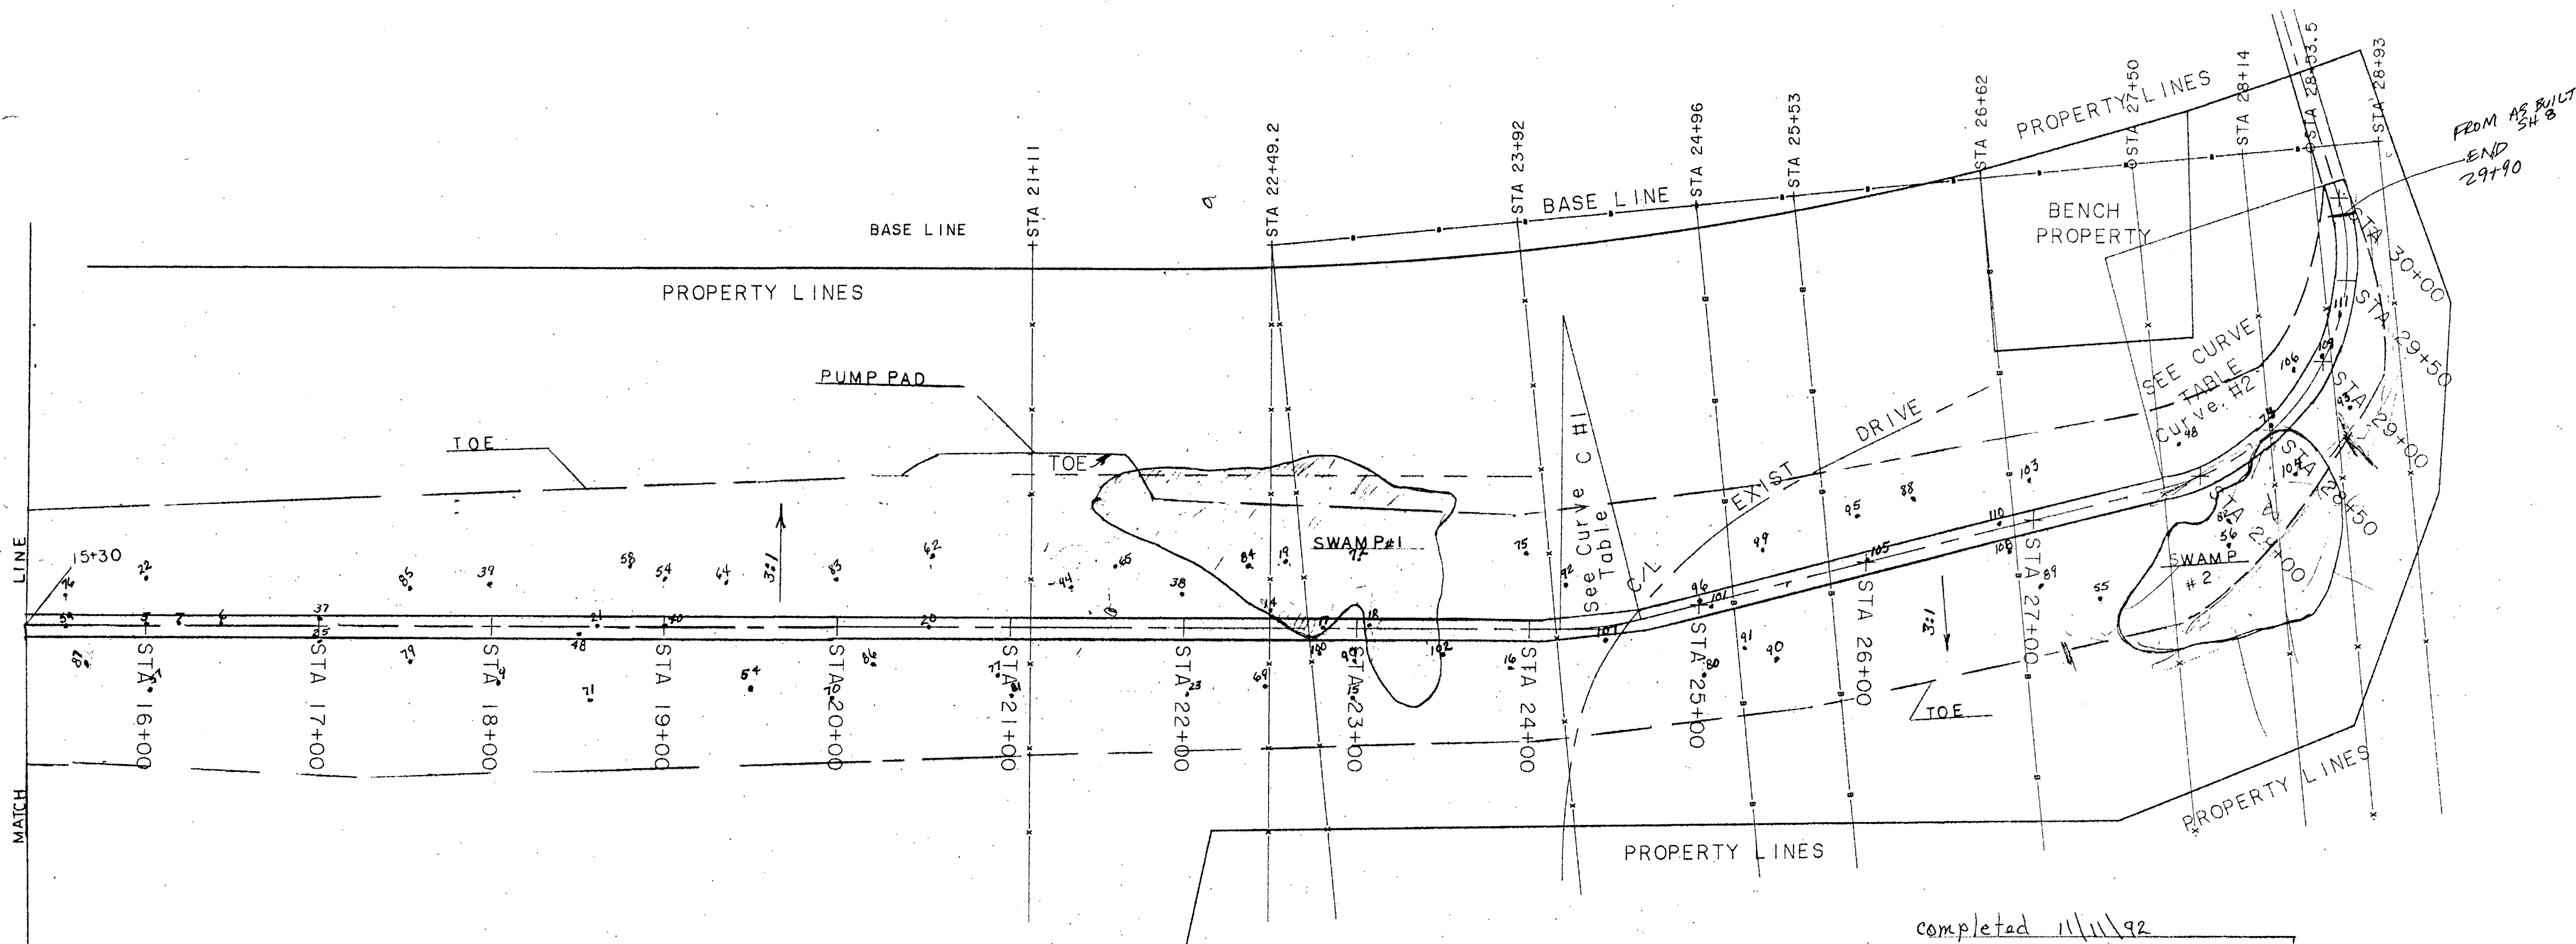

AS-BUILT

completed 11/11/92
SOUTHGATE DIKE
"AS BUILT"
 WILLS CR. WATERSHED
 PL-566
 GUERNSEY CO., OHIO
 Sheet 5A of 9
 Replaces sheet 5 & 6 of 9