Contract No. 50-5E 34-1-168
Contractor CETM Inc.
Date Started; 9/29/91
Completed ; 11/11/92
Gov't Rep.; Robert Keen
Inspector; DALE Goins

U.S. DEPARTMENT OF AGRICUTURE
SOIL CONSERVATION SERVICE
CONSTRUCTION DRAWINGS FOR

WILLS CREEK WATERSHED PROTECTION AND FLOOD PREVENTION PROJECT

BELMONT, GUERNSEY, MUSKINGUM AND NOBLE COUNTIES, OHIO

IN COOPERATION WITH

VILLAGE OF QUAKER CITY
GUERNSEY SOIL AND WATER CONSERVATION DISTRICT
CAMBRIDGE AREA CHAMBER OF COMMERCE
CITY OF CAMBRIDGE
STATE OF OHIO

SOUTHGATE DIKE

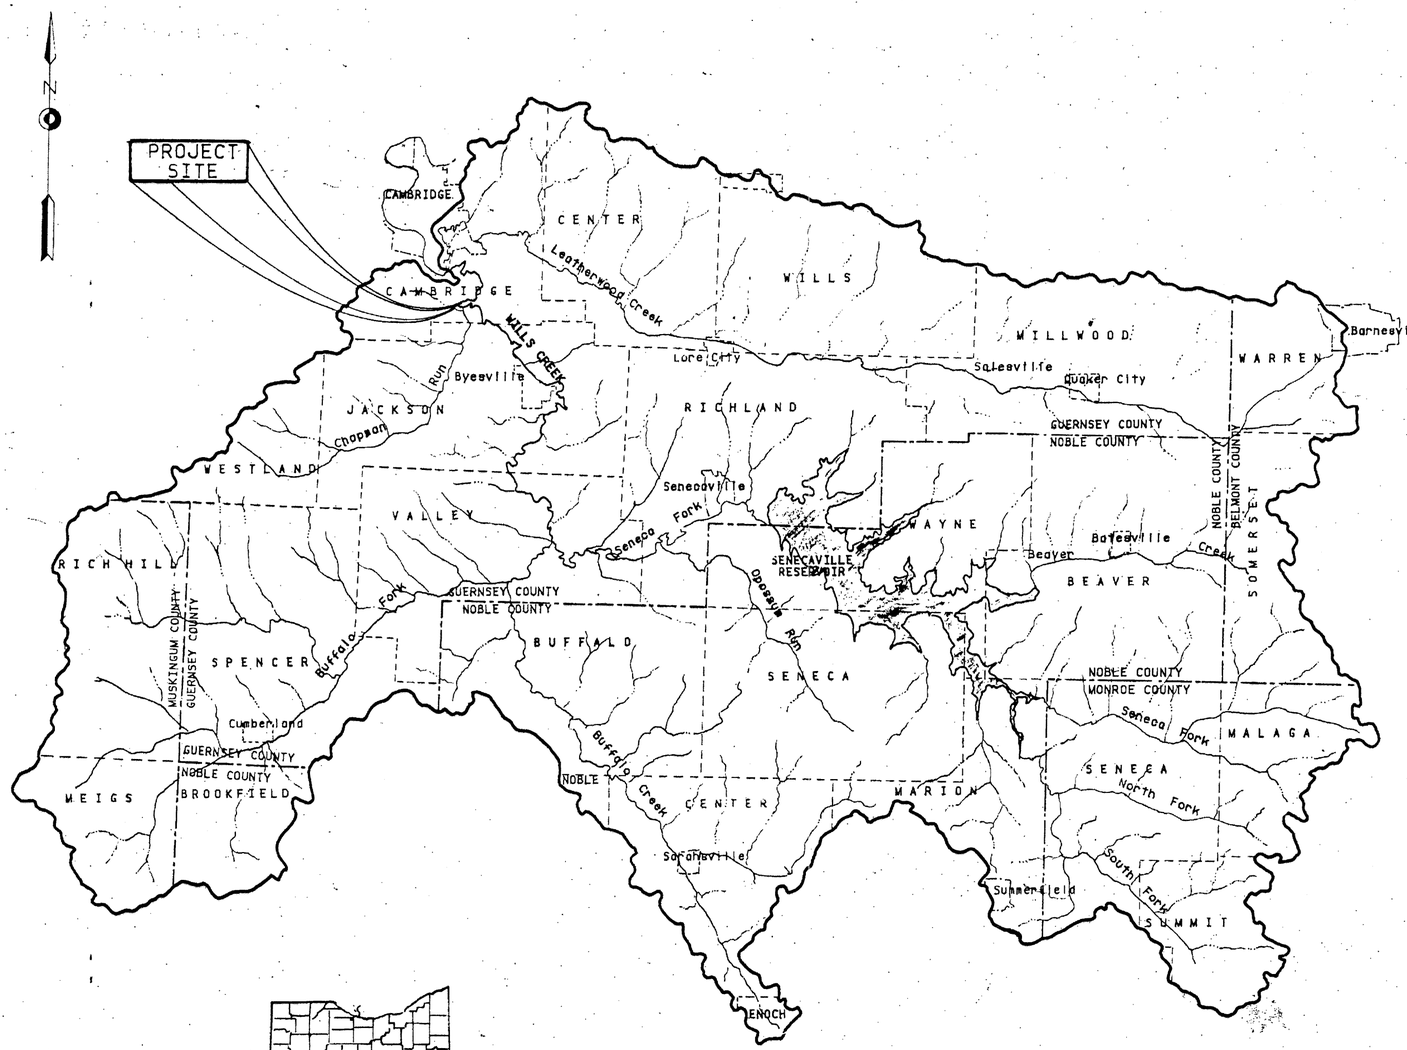

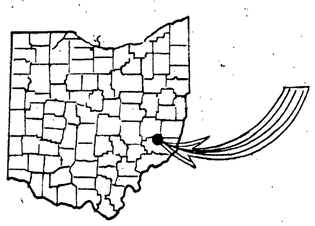

VICINITY MAP

0 1 2 3 4 5
SCALE IN MILES

SHEET INDEX

TITLE	NO
COVER SHEET	1
WORK LOCATION MAP	2
SITE PLAN	3
PLAN VIEW OF DIKE - ℄ 4+40 TO ℄ 9+95	4
PLAN VIEW OF DIKE - ℄ 9+95 TO ℄ 19+98	5
PLAN VIEW OF DIKE - ℄ 19+98 TO ℄ 29+23	6
DETAILS, CROSS-SECTIONS, PROFILES	7
PROFILE ALONG ℄ OF DIKE	8
LOG OF BORINGS	9

AS-BUILT
11/11/92

DRAWING NO OH-870107
Sheet 1 of 8 11

APPROVED BY	DATE
Arthur M. Brate, STATE CONSERVATION ENGINEER	6-21-90
C. Charles Schaub, MAYOR CITY OF CAMBRIDGE	28 Aug 90
Delmar E. Stough, PE/PS, ENGINEER, CITY OF CAMBRIDGE	8-27-90
Dennis L. Hurst, act., HEAD ENGINEERING STAFF M.N.T.C., LINCOLN, NEBRASKA	7-17-90